



BUILDING CODE COMPLIANCE OFFICE (BCCO)  
PRODUCT CONTROL DIVISION

MIAMI-DADE COUNTY, FLORIDA  
METRO-DADE FLAGLER BUILDING  
140 WEST FLAGLER STREET, SUITE 1603  
MIAMI, FLORIDA 33130-1563  
(305) 375-2901 FAX (305) 375-2908

## NOTICE OF ACCEPTANCE (NOA)

[www.maimidade.gov/buildingcode](http://www.maimidade.gov/buildingcode)

Dryvit System, Inc.  
One Energy Way  
West Warrick, RI 02893

### SCOPE:

This NOA is being issued under the applicable rules and regulations governing the use of construction materials. The documentation submitted has been reviewed by Miami-Dade County Product Control Division and accepted by the Board of Rules and Appeals (BORA) to be used in Miami Dade County and other areas where allowed by the Authority Having Jurisdiction (AHJ).

This NOA shall not be valid after the expiration date stated below. The Miami-Dade County Product Control Division (In Miami Dade County) and/or the AHJ (in areas other than Miami Dade County) reserve the right to have this product or material tested for quality assurance purposes. If this product or material fails to perform in the accepted manner, the manufacturer will incur the expense of such testing and the AHJ may immediately revoke, modify, or suspend the use of such product or material within their jurisdiction. BORA reserves the right to revoke this acceptance, if it is determined by Miami-Dade County Product Control Division that this product or material fails to meet the requirements of the applicable building code. This product is approved as described herein, and has been designed to comply with the Florida Building Code, including the High Velocity Hurricane Zone.

### DESCRIPTION: "Exterior Insulation and Finish System"—L.M.I.

**APPROVAL DOCUMENT:** Drawing No. 07-01, titled "Exterior Insulation and Finish System", sheets 1 through 3 of 3, dated 08/25/06, prepared by R. J. Kenney Associates, Inc., signed and sealed by R. E. Kroll, P.E., bearing the Miami-Dade County Product Control Revision stamp with the Notice of Acceptance number and expiration date by the Miami-Dade County Product Control Division.

**LIMITATION:** This system is not to be used on Horizontal surface exposed to weather except as soffit; it is intended to be used as a wall system only.

### MISSILE IMPACT RATING: Large and Small Missile Impact

**LABELING:** Each unit shall bear a permanent label with the manufacturer's name or logo, city, state and following statement: "Miami-Dade County Product Control Approved", unless otherwise noted herein.

**RENEWAL** of this NOA shall be considered after a renewal application has been filed and there has been no change in the applicable building code negatively affecting the performance of this product.

**TERMINATION** of this NOA will occur after the expiration date or if there has been a revision or change in the materials, use, and/or manufacture of the product or process. Misuse of this NOA as an endorsement of any product, for sales, advertising or any other purposes shall automatically terminate this NOA. Failure to comply with any section of this NOA shall be cause for termination and removal of NOA.

**ADVERTISEMENT:** The NOA number preceded by the words Miami-Dade County, Florida, and followed by the expiration date may be displayed in advertising literature. If any portion of the NOA is displayed, then it shall be done in its entirety.

**INSPECTION:** A copy of this entire NOA shall be provided to the user by the manufacturer or its distributors and shall be available for inspection at the job site at the request of the Building Official. This NOA **revises and renews** NOA # 01-0724.08 and consists of this page 1 and evidence pages E-1, as well as approval document mentioned above.

The submitted documentation was reviewed by **Jaime D. Gascon, P.E.**



J. Gascon  
4/25/07

NOA No 06-0608.04  
Expiration Date: September 17, 2011  
Approval Date: May 17, 2007  
Page 1

**Dryvit System, Inc.**

**NOTICE OF ACCEPTANCE: EVIDENCE SUBMITTED**

**A. DRAWINGS**

1. Drawing No. 07-01, titled "Exterior Insulation and Finish System", sheets 1 through 3 of 3, dated 08/25/06, prepared by R. J. Kenney Associates, Inc., signed and sealed by R. E. Kroll, P.E.

**B. TESTS**

1. Test reports on 1) Air Infiltration Test, per FBC, TAS 202-94  
2) Uniform Static Air Pressure Test, Loading per FBC TAS 202-94  
3) Water Resistance Test, per FBC, TAS 202-94  
4) Large Missile Impact Test per FBC, TAS 201-94  
5) Cyclic Wind Pressure Loading per FBC, TAS 203-94  
along with marked-up drawings and installation diagram of "Exterior Insulation and Finish System", prepared by ETC Laboratories, Test Report No. ETC-06-1059-17956.0, dated October 30, 2006, signed and sealed by Joseph Labora Doldan, P.E.
2. Tensile Test Report per ASTM C297 on Primus & Genesis Products by Architectural Testing Inc., Test Report No. 01-30333.02, dated 12/15/97, signed and sealed by R. E. Kroll, PE.

**C. CALCULATIONS**

N/A

**D. QUALITY ASSURANCE**

1. Miami Dade Building Code Compliance Office (BCCO).

**E. MATERIAL CERTIFICATIONS**


1. Notice of Acceptance No. **06-1011.05** issued to Dyplast Products, LLC. for their "**Expanded Polystyrene Block Type Insulation**" dated 05/10/2007, expiring on 01/11/2008.


**F. STATEMENTS**

1. Test compliance letter, in report ETC-06-1059-17956.0, issued by ETC Laboratories on 11/28/06 signed and sealed by Joseph Labora Doldan, P.E.
2. No financial interest letter issued by Dryvit Systems, Inc. on 03/28/2007, signed by W. M. Preston and notarized by L. A. Rollins.
3. No change letter issued by Dryvit Systems, Inc. on 03/28/2007, signed by W. M. Preston.

**G. OTHER**

N/A

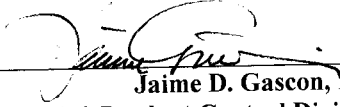  
Jaime D. Gascon, P.E.  
Chief, Product Control Division  
NOA No 06-0608.04  
Expiration Date: September 17, 2011  
Approval Date: May 17, 2007

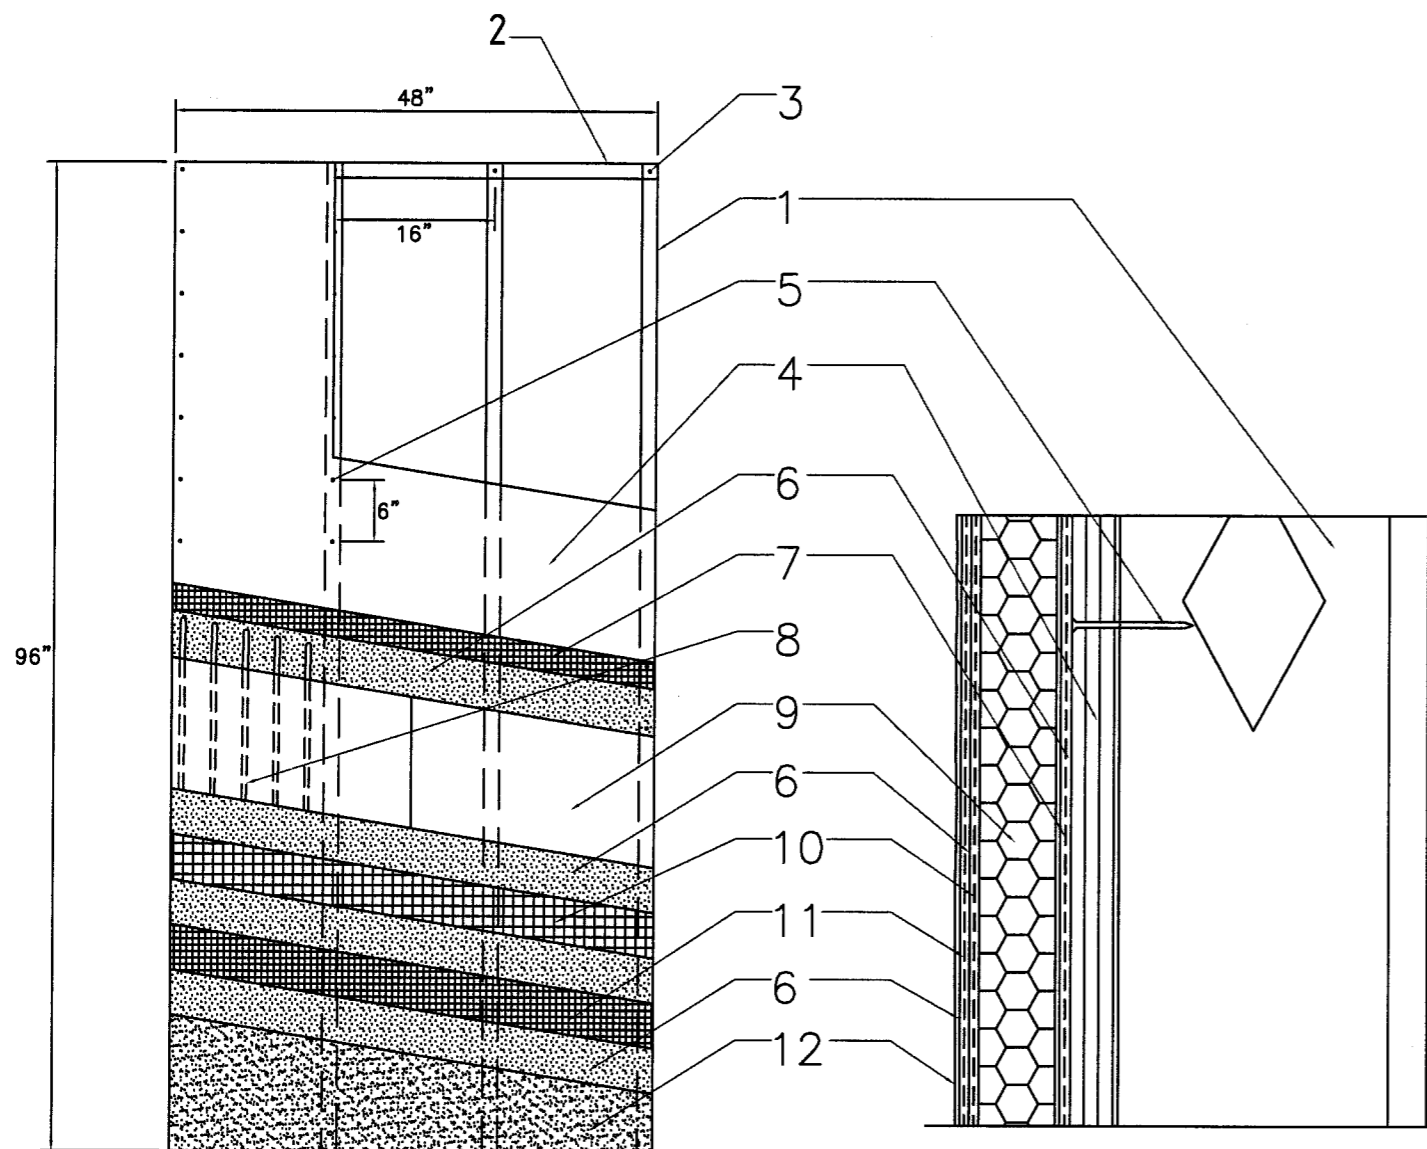

## MATERIAL LIST

- ① 3 5/8" X 1 5/8" X 18 GAUGE STEEL STUDS AT 16" O.C.
- ② 3 5/8" X 18 GA. STEEL TRACK
- ③ MINIMUM 1/2 TEK SCREWS TO SECURE STEEL TRACK TO STEEL STUDS ON INTERIOR AND EXTERIOR
- ④ 1/2" EXTERIOR GRADE GYPSUM SHEATHING MEETING ASTM C 1396 (FORMALLY ASTM C 79) OR 1/2" DENS-GLASS GOLD MEETING ASTM C 1177
- ⑤ MINIMUM NO. 8 x 1 5/8" WAFFER HEAD SCREWS SPACED AT 6" O.C. ALONG VERTICAL STUDS
- ⑥ DRYVIT BASE COAT: PRIMUS®, GENESIS®, OR GENESIS® DM; PRIMUS OR GENESIS IS MIXED 1:1 BY WEIGHT WITH PORTLAND CEMENT AND WATER. PRIMUS AND GENESIS ARE 100 PERCENT POLYMER-BASED PRODUCTS. GENESIS DM IS A DRY MIX THAT IS MIXED WITH WATER
- ⑦ DRYVIT'S STANDARD PLUS REINFORCING MESH: 6 OZ/ SQ. YD. FIBERGLASS REINFORCING MESH EMBEDDED IN THE DRYVIT BASE COAT. THE STANDARD PLUS REINFORCING MESH SHALL BE LAPPED A MINIMUM OF 2 1/2" AT ALL EDGES
- ⑧ ADHERE THE EXPANDED POLYSTYRENE (EPS) INSULATION BOARD WITH DRYVIT'S PRIMUS, GENESIS OR GENESIS DM MIXTURE. THE ADHESIVE IS APPLIED WITH A 3/8" X 3/8" NOTCHED TROWEL WITH NOTCHES SPACED A MAXIMUM OF 1 1/2" O.C. THE ADHESIVE SHALL BE APPLIED TO THE BACK SIDE OF THE EPS IN A VERTICAL ORIENTATION
- ⑨ MINIMUM 1" THICK INSULATION BOARD MEETING DRYVIT SPECIFICATION DS131. INSULATION BOARD SUPPLIER SHALL POSSESS A CURRENT NOA WITH MIAMI DADE COUNTY
- ⑩ DRYVIT PANZER 20 REINFORCING MESH: 20.5 OZ/ SQ. YD. FIBERGLASS REINFORCING MESH EMBEDDED IN THE DRYVIT BASE COAT. PANZER 20 MESH EDGES SHALL BE ABUTTED TIGHTLY. DO NOT OVERLAP
- ⑪ DRYVIT'S STANDARD REINFORCING MESH: 4.3 OZ/SQ. YD FIBERGLASS REINFORCING MESH EMBEDDED IN THE DRYVIT BASE COAT. THE STANDARD REINFORCING MESH SHALL BE LAPPED A MINIMUM OF 2 1/2" AT ALL EDGES.
- ⑫ DRYVIT FINISH: A 100 PERCENT ACRYLIC BASED MATERIAL AVAILABLE IN VARIOUS TEXTURES.

## GENERAL NOTES

1. THE SYSTEM HAS BEEN DESIGNED IN ACCORDANCE WITH THE SOUTH FLORIDA BUILDING CODE 2004 EDITION AND ITS LATEST SUPPLEMENTS.
2. THIS SYSTEM HAS BEEN TESTED IN ACCORDANCE WITH MIAMI DADE COUNTY PROTOCOLS TAS 201, TAS 202 AND TAS 203; IMPACT, STRUCTURAL AND CYCLIC TESTING
3. THIS SYSTEM SHALL BE APPLIED BY A LICENSED PLASTERING CONTRACTOR FOLLOWING THIS NOTICE OF ACCEPTANCE THE RECOMMENDATION OF DRYVIT SYSTEMS, INC. AND THE APPLICABLE SECTIONS OF THE ~~SOUTH~~ FLORIDA BUILDING CODE. *3la.*
4. THE ENGINEER AND/OR ARCHITECT OF RECORD FOR EACH PROJECT USING THIS SYSTEM SHALL SIZE ALL STUD FRAMING TO ENSURE CONFORMANCE WITH STUD DEFLECTION AND STRESS LIMITATIONS AS REQUIRED BY ALL GOVERNING CODES AND THIS DOCUMENT.
5. INSULATION BOARDS SHALL BE POSITIONED IN A RUNNING BOND PATTERN.
6. ALL STUDS USED WITH THIS SYSTEM SHALL BE COMPLETELY SHEATHED AT THE INTERIOR FLANGE OR BRIDGED AT A MAXIMUM OF EVERY 5' OF STUD LENGTH OR AS SPECIFIED BY THE STUD MANUFACTURER.
7. ALL STEEL STUDS SHALL BE STRUCTURAL WITH 1 5/8" MINIMUM FLANGE WIDTH AND HAVE A MINIMUM YIELD STRENGTH OF 33000 PSI.
8. DETAILS ON SHEETS 2 AND 3 OF 3 ARE TYPICAL AND SHOW INTENT TO PREVENT WATER INFILTRATION INTO AND BEHIND THIS SYSTEM. ALTERNATE DETAILS AND SPECIFIC CONDITIONS NOT COVERED BY THE TYPICAL DETAILS ARE THE RESPONSIBILITY OF THE LICENSED DESIGN PROFESSIONALS IN CONSULTATION WITH DRYVIT SYSTEMS, INC.





PRODUCT REVISED  
as complying with the Florida  
Building Code  
Acceptance No. 06-0608.04  
Expiration Date 09/15/2011  
*[Signature]*  
Miami Dade Product Control  
Division

DESIGN PRESSURE

+75psf      -75psf

*Revised*  
*2/12/07*

DRYVIT SYSTEMS, INC. One Energy Way West Warwick, Rhode Island		
DWG. NO.: 07-01 Large Scale Missile- 1/2" Exterior Grade Gypsum Sheathing		
SHEET NO: 1 OF 3	ISSUE DATE: 08/25/06	REV. DATE:

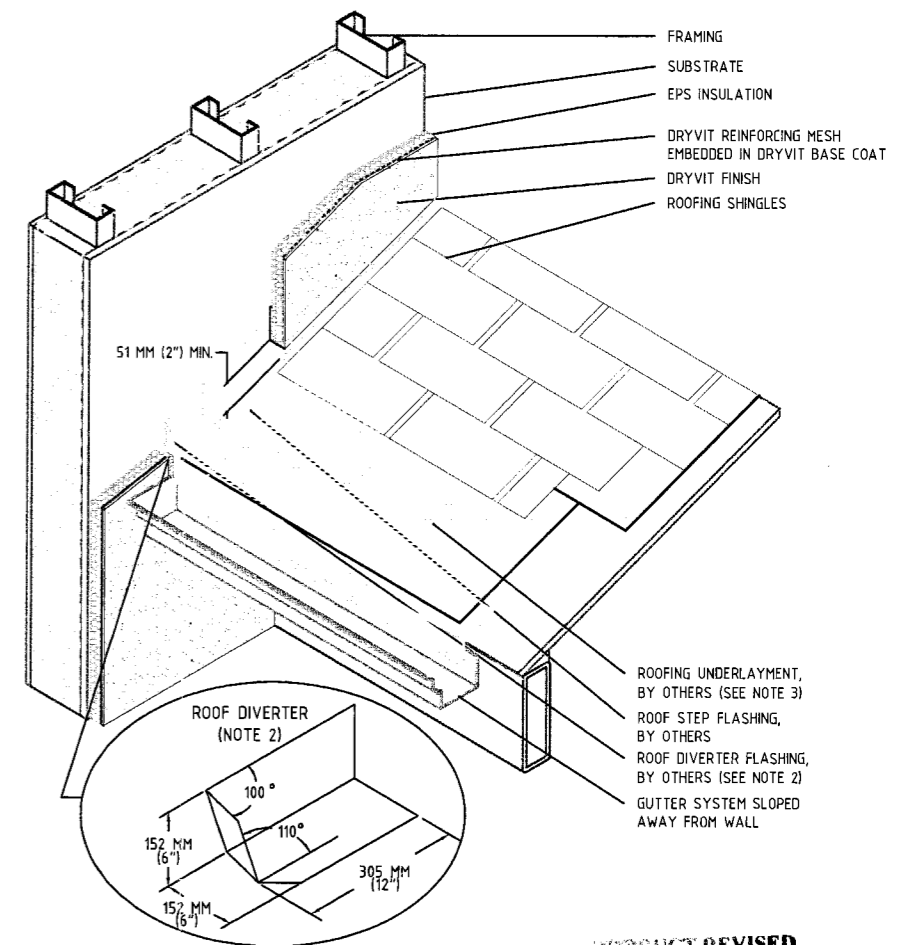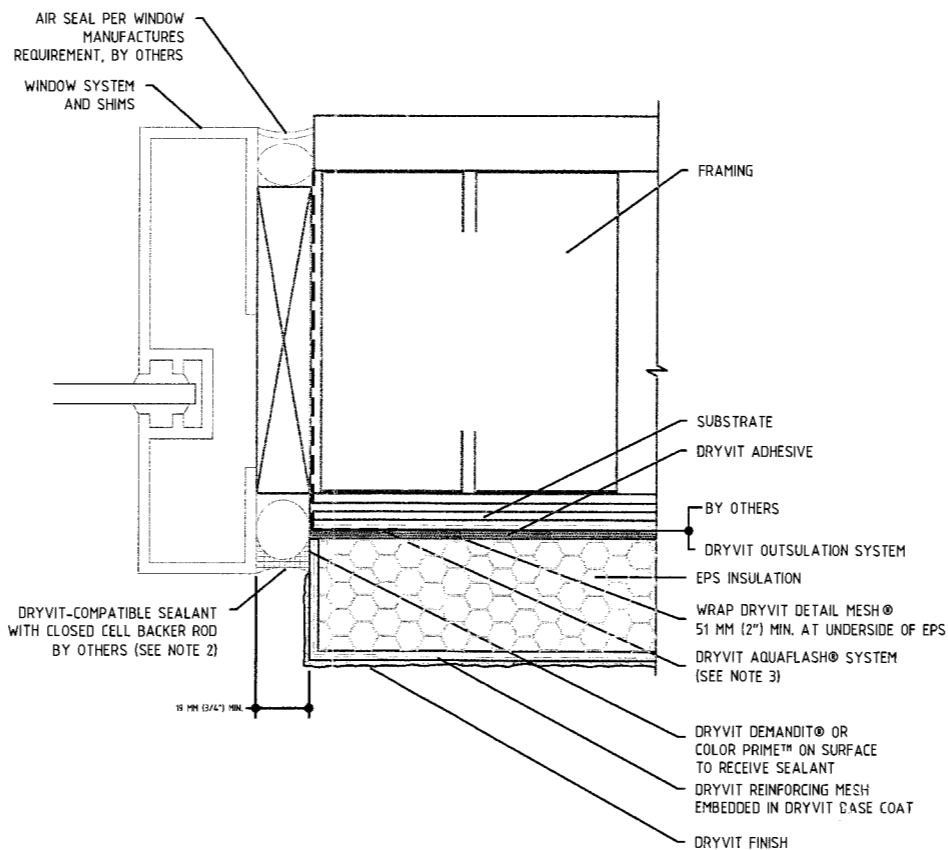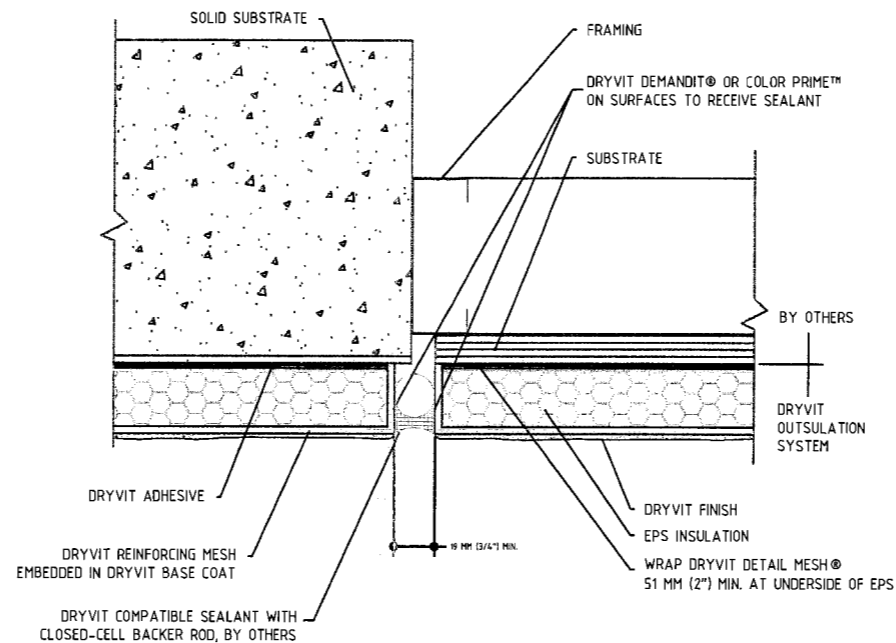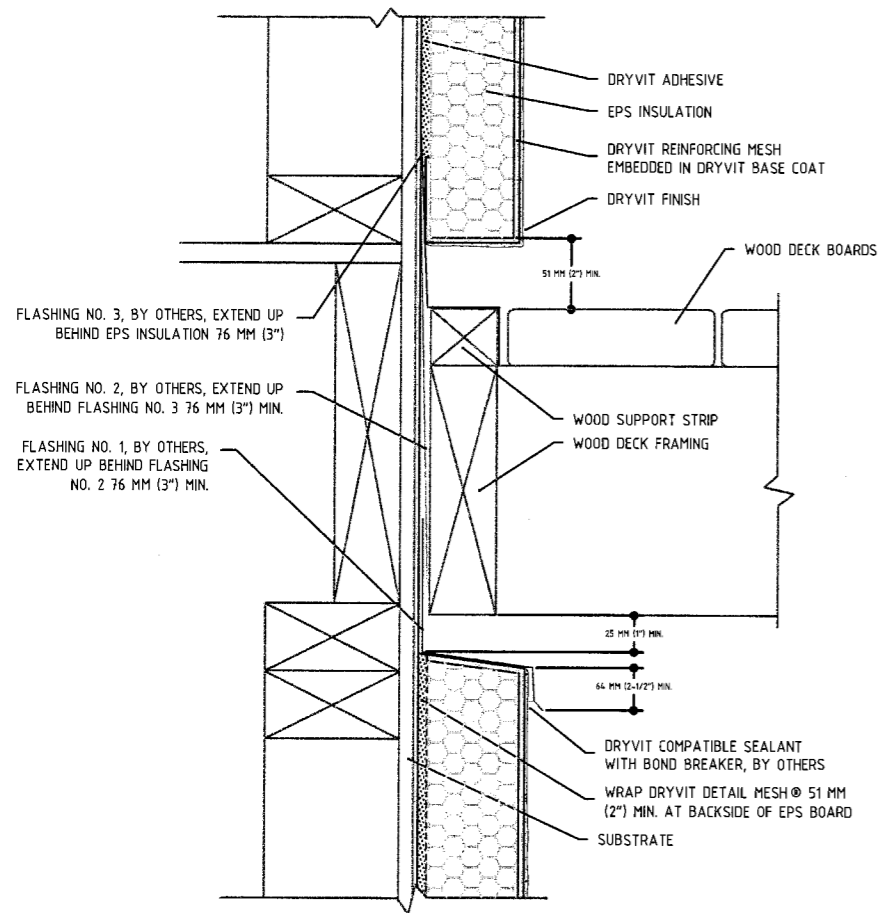





**Notes:**

1. Gap wood sheathing edge and end joints in accordance with APA (American Plywood Association) recommendations.
2. Seal Penetrations through flashing where attached to framing
3. Distance of EIFS to deck varies with climate. Allow sufficient distance to prevent snow/ice and puddling water against system.
4. provide end dams where flashings terminate at ends of deck.
5. Pressure treated wood (space from flashing or rout backside to provide drainage

**PRODUCT REVISED**  
as complying with the Florida  
Building Code  
Acceptance No 06-0608-04  
Expiration Date 09/17/2011  
By *[Signature]*  
Miami Dade Product Control  
Division

*Rekall*  
2/12/07

<b>DRYVIT SYSTEMS, INC.</b> One Energy Way West Warwick, Rhode Island		
DWG. NO.: 07-01 Dryvit Outsulation System Large Scale Impact		
SHEET NO: 2 OF 3	ISSUE DATE: 08/25/06	REV/ DATE:

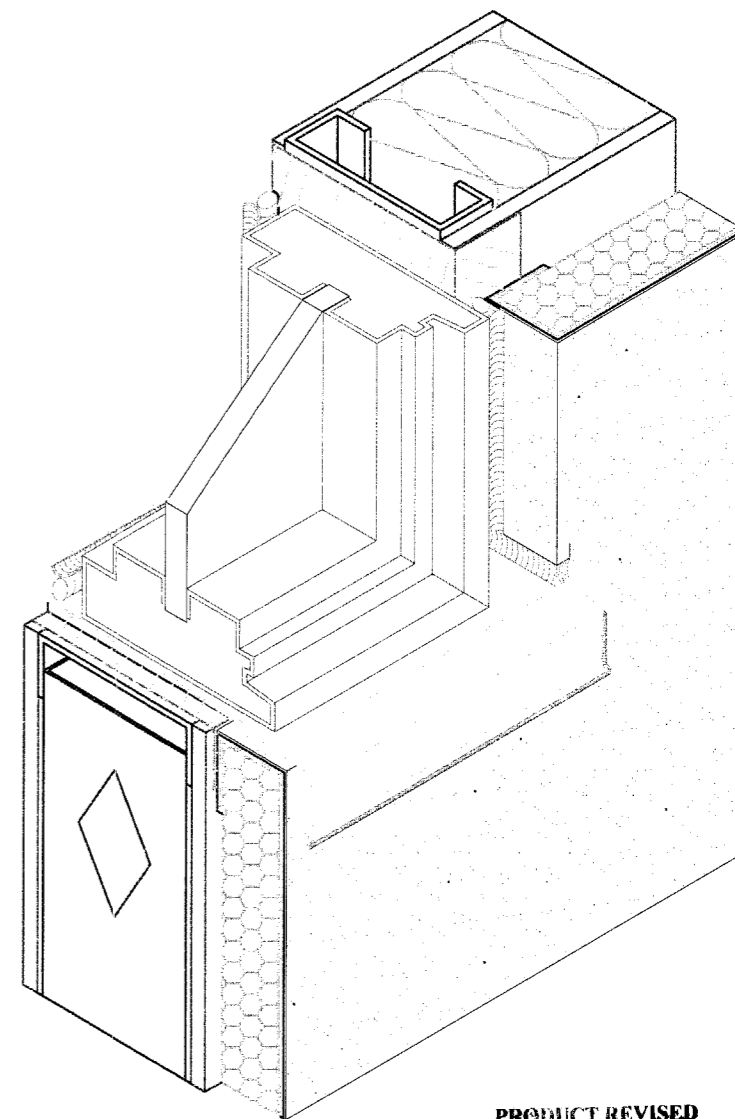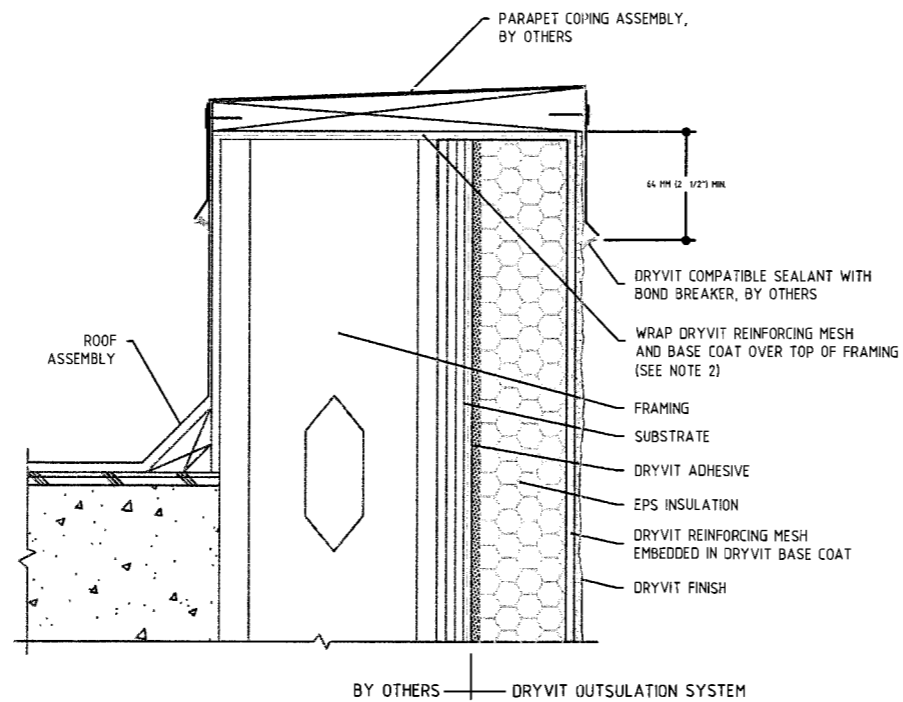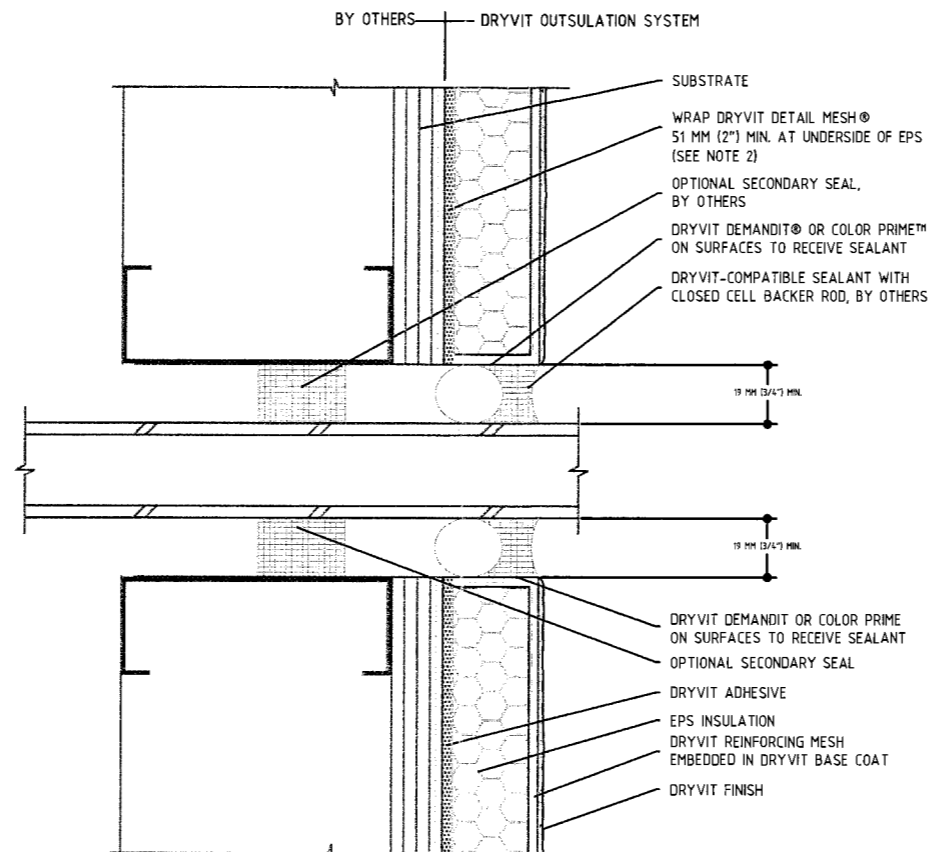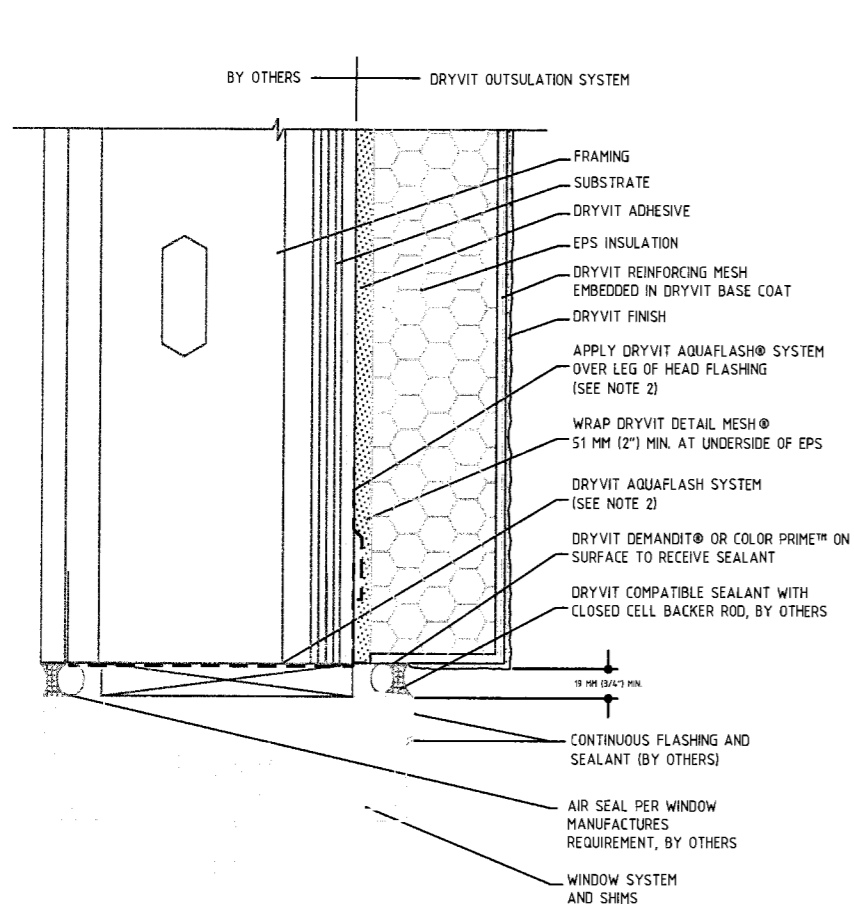

PRODUCT REVISED  
as complying with the Florida  
Building Code  
Acceptance No. 06-0608-04  
Expiration Date 09/17/2011  
By *[Signature]*  
Miami Code Product Control  
Division

*Reborell*  
2/12/07

DRYVIT SYSTEMS, INC. One Energy Way West Warwick, Rhode Island		
DWG. NO.: 07-01 Dryvit Outsulation System Large Scale Impact		
SHEET NO: 3 OF 3	ISSUE DATE: 08/25/06	REV./ DATE: